


Floor plan
2/12/12

NORTH

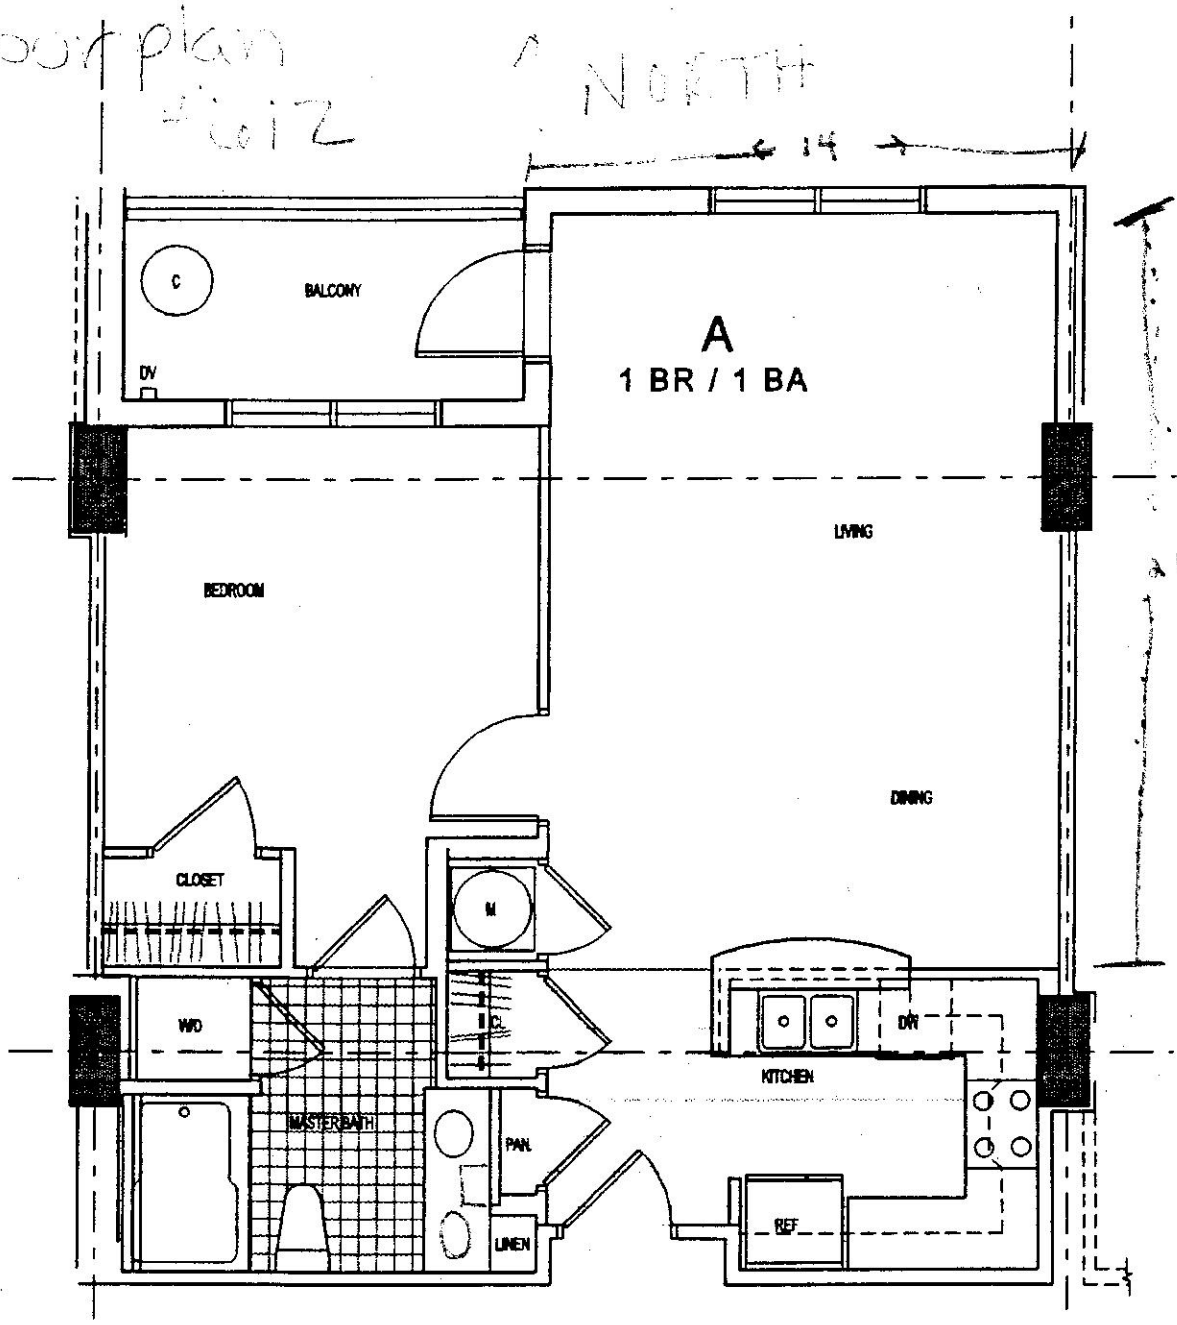

1 UNIT A
3/16" = 1'-0"

APPROXIMATELY 764 SF

THIS LAYOUT REPRESENTS, TO THE BEST OF OUR KNOWLEDGE, THE GENERAL UNIT CONFIGURATION AS CONSTRUCTED AT PARK CENTRAL CONDOMINIUMS, ATLANTA, GEORGIA

[Signature]
REPRESENTATIVE FOR AI GROUP ARCHITECTS, P.C.